THIS DRAWING IS UNPUBLISHED. RELEASED FOR PUBLICATION -,- .
© COPYRIGHT - BY TYCO ELECTRONICS CORPORATION. ALL RIGHTS RESERVED.

LOC	DIST
G	02

REVISIONS

P	LTR	DESCRIPTION	DATE	DWN	APVD
	J1	REV PER ECR 07-017037	20JUL07	JR	TM

AMP WIRE RANGE	AMP INSULATION RANGE
22-16 AWG 0.3-1.5 mm2	.140 MAX DIA 3.5 MAX DIA

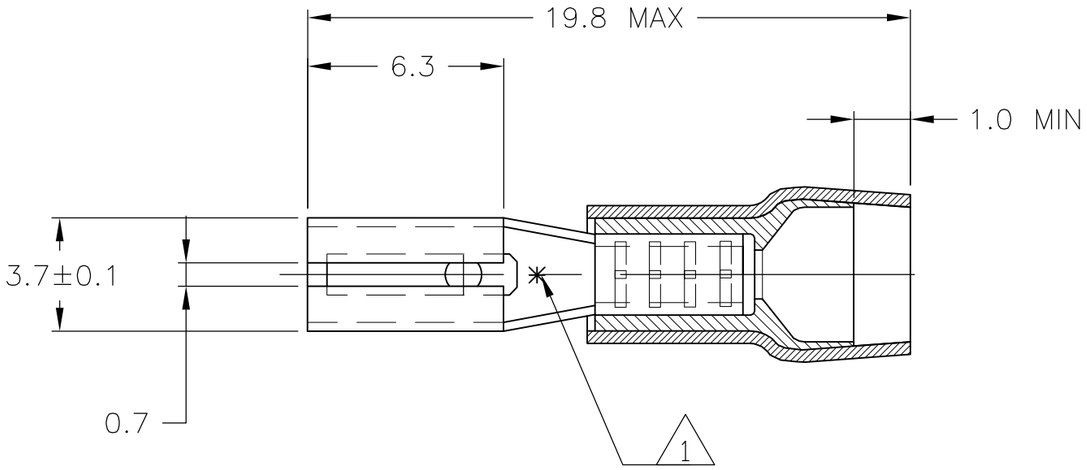

1 ASTERISK * FOR PHOS BRONZE VERSION ONLY

2 OBSOLETE W/O REPLACEMENT

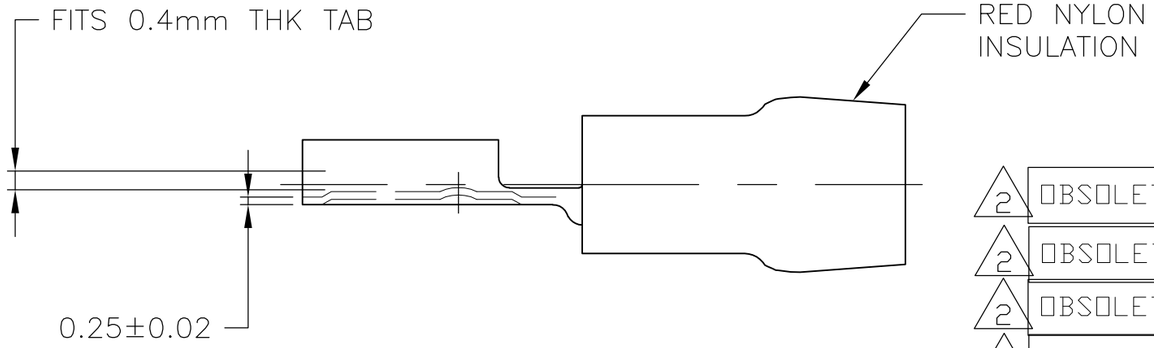

	PN ON TAPE	FINISH	MATERIAL	PART NUMBER
2 OBSOLETE		~~GOLD~~	~~PHOS BRONZE~~	~~165564-6~~
2 OBSOLETE		~~GOLD~~	~~BRASS~~	~~165564-5~~
2 OBSOLETE		~~SILVER~~	~~PHOS BRONZE~~	~~165564-4~~
2 OBSOLETE		~~SILVER~~	~~BRASS~~	~~165564-3~~
2 OBSOLETE	~~2-165564-2~~	~~TIN~~	~~PHOS BRONZE~~	~~165564-2~~
	~~2-165564-1~~	TIN	BRASS	165564-1

THIS DRAWING IS A CONTROLLED DOCUMENT.

DIMENSIONS: mm

TOLERANCES UNLESS OTHERWISE SPECIFIED:

0 PLC	± -
1 PLC	± 0.2
2 PLC	± -
3 PLC	± -
4 PLC	± -
ANGLES	± 5°

MATERIAL: -

FINISH: -

DWN	jr ruth	15APR05
CHK	T MICHIELUTTI	15APR05
APVD	T MICHIELUTTI	15APR05
PRODUCT SPEC	-	
APPLICATION SPEC	-	
WEIGHT	-	

Tyco Electronics

Tyco Electronics Corporation
Harrisburg, Pa 17105-3608

NAME: RECEPTACLE, FASTON, PIDG, .110 SERIES
-

SIZE	CAGE CODE	DRAWING NO	RESTRICTED TO
A3	00779	C-165564	-

CUSTOMER DRAWING

SCALE	SHEET	REV
5:1	1 OF 1	J1