THIS DRAWING IS UNPUBLISHED. RELEASED FOR PUBLICATION , .
© COPYRIGHT 2009 By – ALL RIGHTS RESERVED.

LOC	DIST
A1	

REVISIONS

P	LTR	DESCRIPTION	DATE	DWN	APVD
	Y2	Released as per ECR-09-017573	10.Aug.09	SRE	PCH
	Y3	REVISED PER ECO-09-023929	23OCT09	KK	AEG
	Y4	ECR-10-026307	14JAN11	KK	HMR

GEGENSTECKER/KONTAKT: ☒ 825 440 ☒ 167 301-4
MATED WITH:

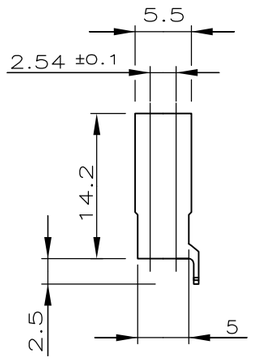

ZWEIREIHIG

POLZ. PRO REIHE	L-0.2	BESTELL-NR.		
–	–		–	
2	5.08	925 370	-2	
3	7.62		-3	
4	10.16		-4	
5	12.70		-5	
6	15.24		-6	
7	17.78		-7	
8	20.32		-8	
9	22.86		-9	
10	25.40	1-	-0	
11	27.94	1-	-1	
12	30.48	1-	-2	
13	33.02	1-	-3	
14	35.56	~~1-~~	~~4~~	OBSOLETE
15	38.10	1-	-5	
16	40.64	1-	-6	
17	43.18	~~1-~~	~~7~~	OBSOLETE
18	45.72	~~1-~~	~~8~~	OBSOLETE
19	48.26	~~1-~~	~~9~~	OBSOLETE
20	50.80	~~2-~~	~~0~~	OBSOLETE
21	53.34	~~2-~~	~~1~~	OBSOLETE
22	55.88	~~2-~~	~~2~~	△1
23	58.42	~~2-~~	~~3~~	
24	60.96	2-	-4	
25	63.50	~~2-~~	~~5~~	OBSOLETE
26	66.04	~~2-~~	~~6~~	△1
27	68.58	~~2-~~	~~7~~	
28	71.12	~~2-~~	~~8~~	
29	73.66	~~2-~~	~~9~~	
30	76.20	3-	-0	
31	78.74	~~3-~~	~~1~~	OBSOLETE △1
32	81.28	~~3-~~	~~2~~	OBSOLETE
33	83.82	~~3-~~	~~3~~	OBSOLETE △1
34	86.36	3-	-4	
35	88.90	~~3-~~	~~5~~	
36	91.44	~~3-~~	~~6~~	
37	93.98	~~3-~~	~~7~~	
38	96.52	~~3-~~	~~8~~	
39	99.06	~~3-~~	~~9~~	
40	101.60	~~4-~~	~~0~~	
41	104.14	~~4-~~	~~1~~	OBSOLETE
42	106.68	~~4-~~	~~2~~	△1
43	109.22	~~4-~~	~~3~~	
44	111.76	~~4-~~	~~4~~	
45	114.30	~~4-~~	~~5~~	
46	116.84	~~4-~~	~~6~~	
47	119.38	~~4-~~	~~7~~	
48	121.92	~~4-~~	~~8~~	
49	124.46	~~4-~~	~~9~~	
50	127.00	5- 925 370	-0	

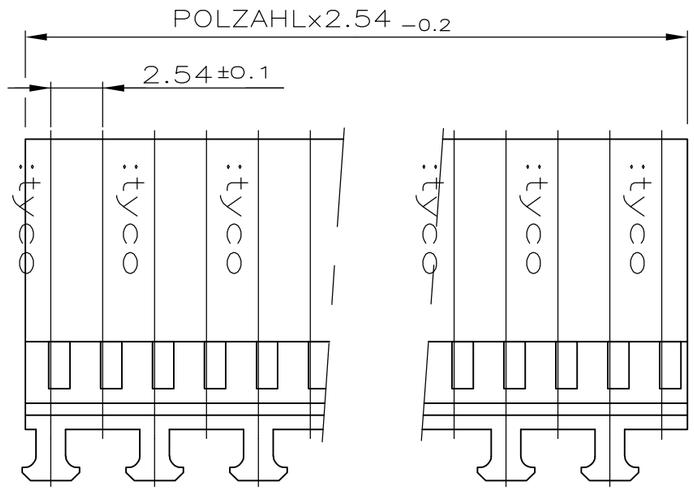

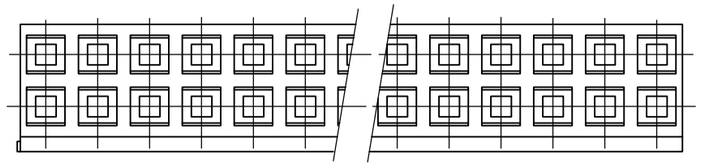

RAST-NOPPENSTELLUNG WECHSELT PRODUKTIONSBEDINGT.
NOPPEN VERRASTEN ENTSPRECHEND LINKS ODER RECHTS MIT STIFTLEISTE.

POSITIONS OF LOCKING DEVICE CHANGED CONDITIONAL OF PRODUCTION.
KNUPS LOCK ACCORDING ON THE LEFT OR RIGHT SIDE WITH PIN HEADER.

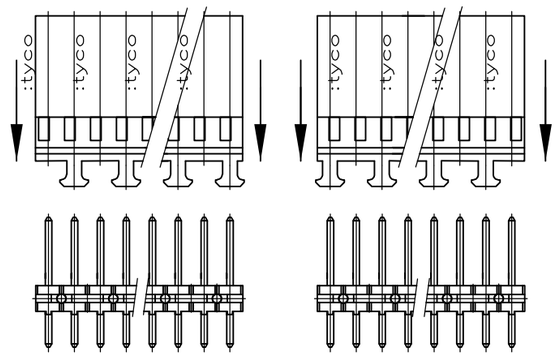

△1 OBSOLETE PARTS: OBSOLETE CIS STREAMLINING PER D.RENAUD/D.SINISI

Drawing valid from CW 32/95
ZEICHNUNG GüLTIG AB KW 32/95

THIS DRAWING IS A CONTROLLED DOCUMENT.

DIMENSIONS: mm

TOLERANCES UNLESS OTHERWISE SPECIFIED:
0 PLC ± 0.2mm
1 PLC ± 0.2mm
2 PLC ± 0.2mm
3 PLC ± 0.2mm
4 PLC ± 0.2mm
ANGLES ± –

MATERIAL: Polyamid
FINISH: Green RAL 6011

DWN DAHLHEIMER 05.12.75
CHK KREPP
APVD
PRODUCT SPEC –
APPLICATION SPEC –
WEIGHT –

TE Connectivity

NAME: AMPMODU IV GEHAEUSE, EINREIHIG
Housing, single row

SIZE	CAGE CODE	DRAWING NO	RESTRICTED TO
A3	00779	C-925370	–

CUSTOMER DRAWING | SCALE 2:1 | SHEET 1 OF 1 | REV Y4